

KEY

- PREFERRED LINE ROUTE, SEPTEMBER 2017
- PROPOSED LINE ROUTE, FEBRUARY 2017 (FROM SCOPING REPORT)
- PROPOSED LINE ROUTE, NOVEMBER 2016 (FROM UPDATED LINE ROUTE REPORT)

Notes:

The Draft Order Limits comprises the construction and operations corridor, temporary access, laydown areas, undergrounding of the new 132 kV cable, and the undergrounding of existing lower voltage overhead line where indicated.


The Construction and Operations corridor generally has a width of 25m in total, centred on the Preferred Line Route. In general, the corridor width for undergrounding is 10m and the corridor for access routes is 5m.




BACKGROUND MAPPING INFORMATION HAS BEEN REPRODUCED FROM THE ORDNANCE SURVEY MAP BY PERMISSION OF ORDNANCE SURVEY ON BEHALF OF THE CONTROLLER OF HER MAJESTY'S STATIONERY OFFICE. CROWN COPYRIGHT AND DATABASE RIGHTS 2017. ORDNANCE SURVEY 0100031873. CONTAINS OS DATA © CROWN COPYRIGHT AND DATABASE RIGHT 2017.



o	14/11/2017	PEIR	KC	ZF	SG
Rev	Date	Description	Made	Chkd	App'd
Scheme Name: REINFORCEMENT TO NORTH SHROPSHIRE ELECTRICITY DISTRIBUTION NETWORK: 132 kV ELECTRICAL CIRCUIT FROM OSWESTRY TO WEM					
Chapter: CHAPTER 4: CONSULTATION					
Document Title: FIGURE 4.1 EARLIER AMENDMENTS TO THE PREFERRED LINE ROUTE					
Drawn: KC	Checked: ZF	Approved: SG	Date: 14/11/2017	Sheet: 1 OF 1	Rev: 0
Document Type: FIGURE		Scale: 1:55,000		Sheet Size: A3 (420 mm x 297 mm)	

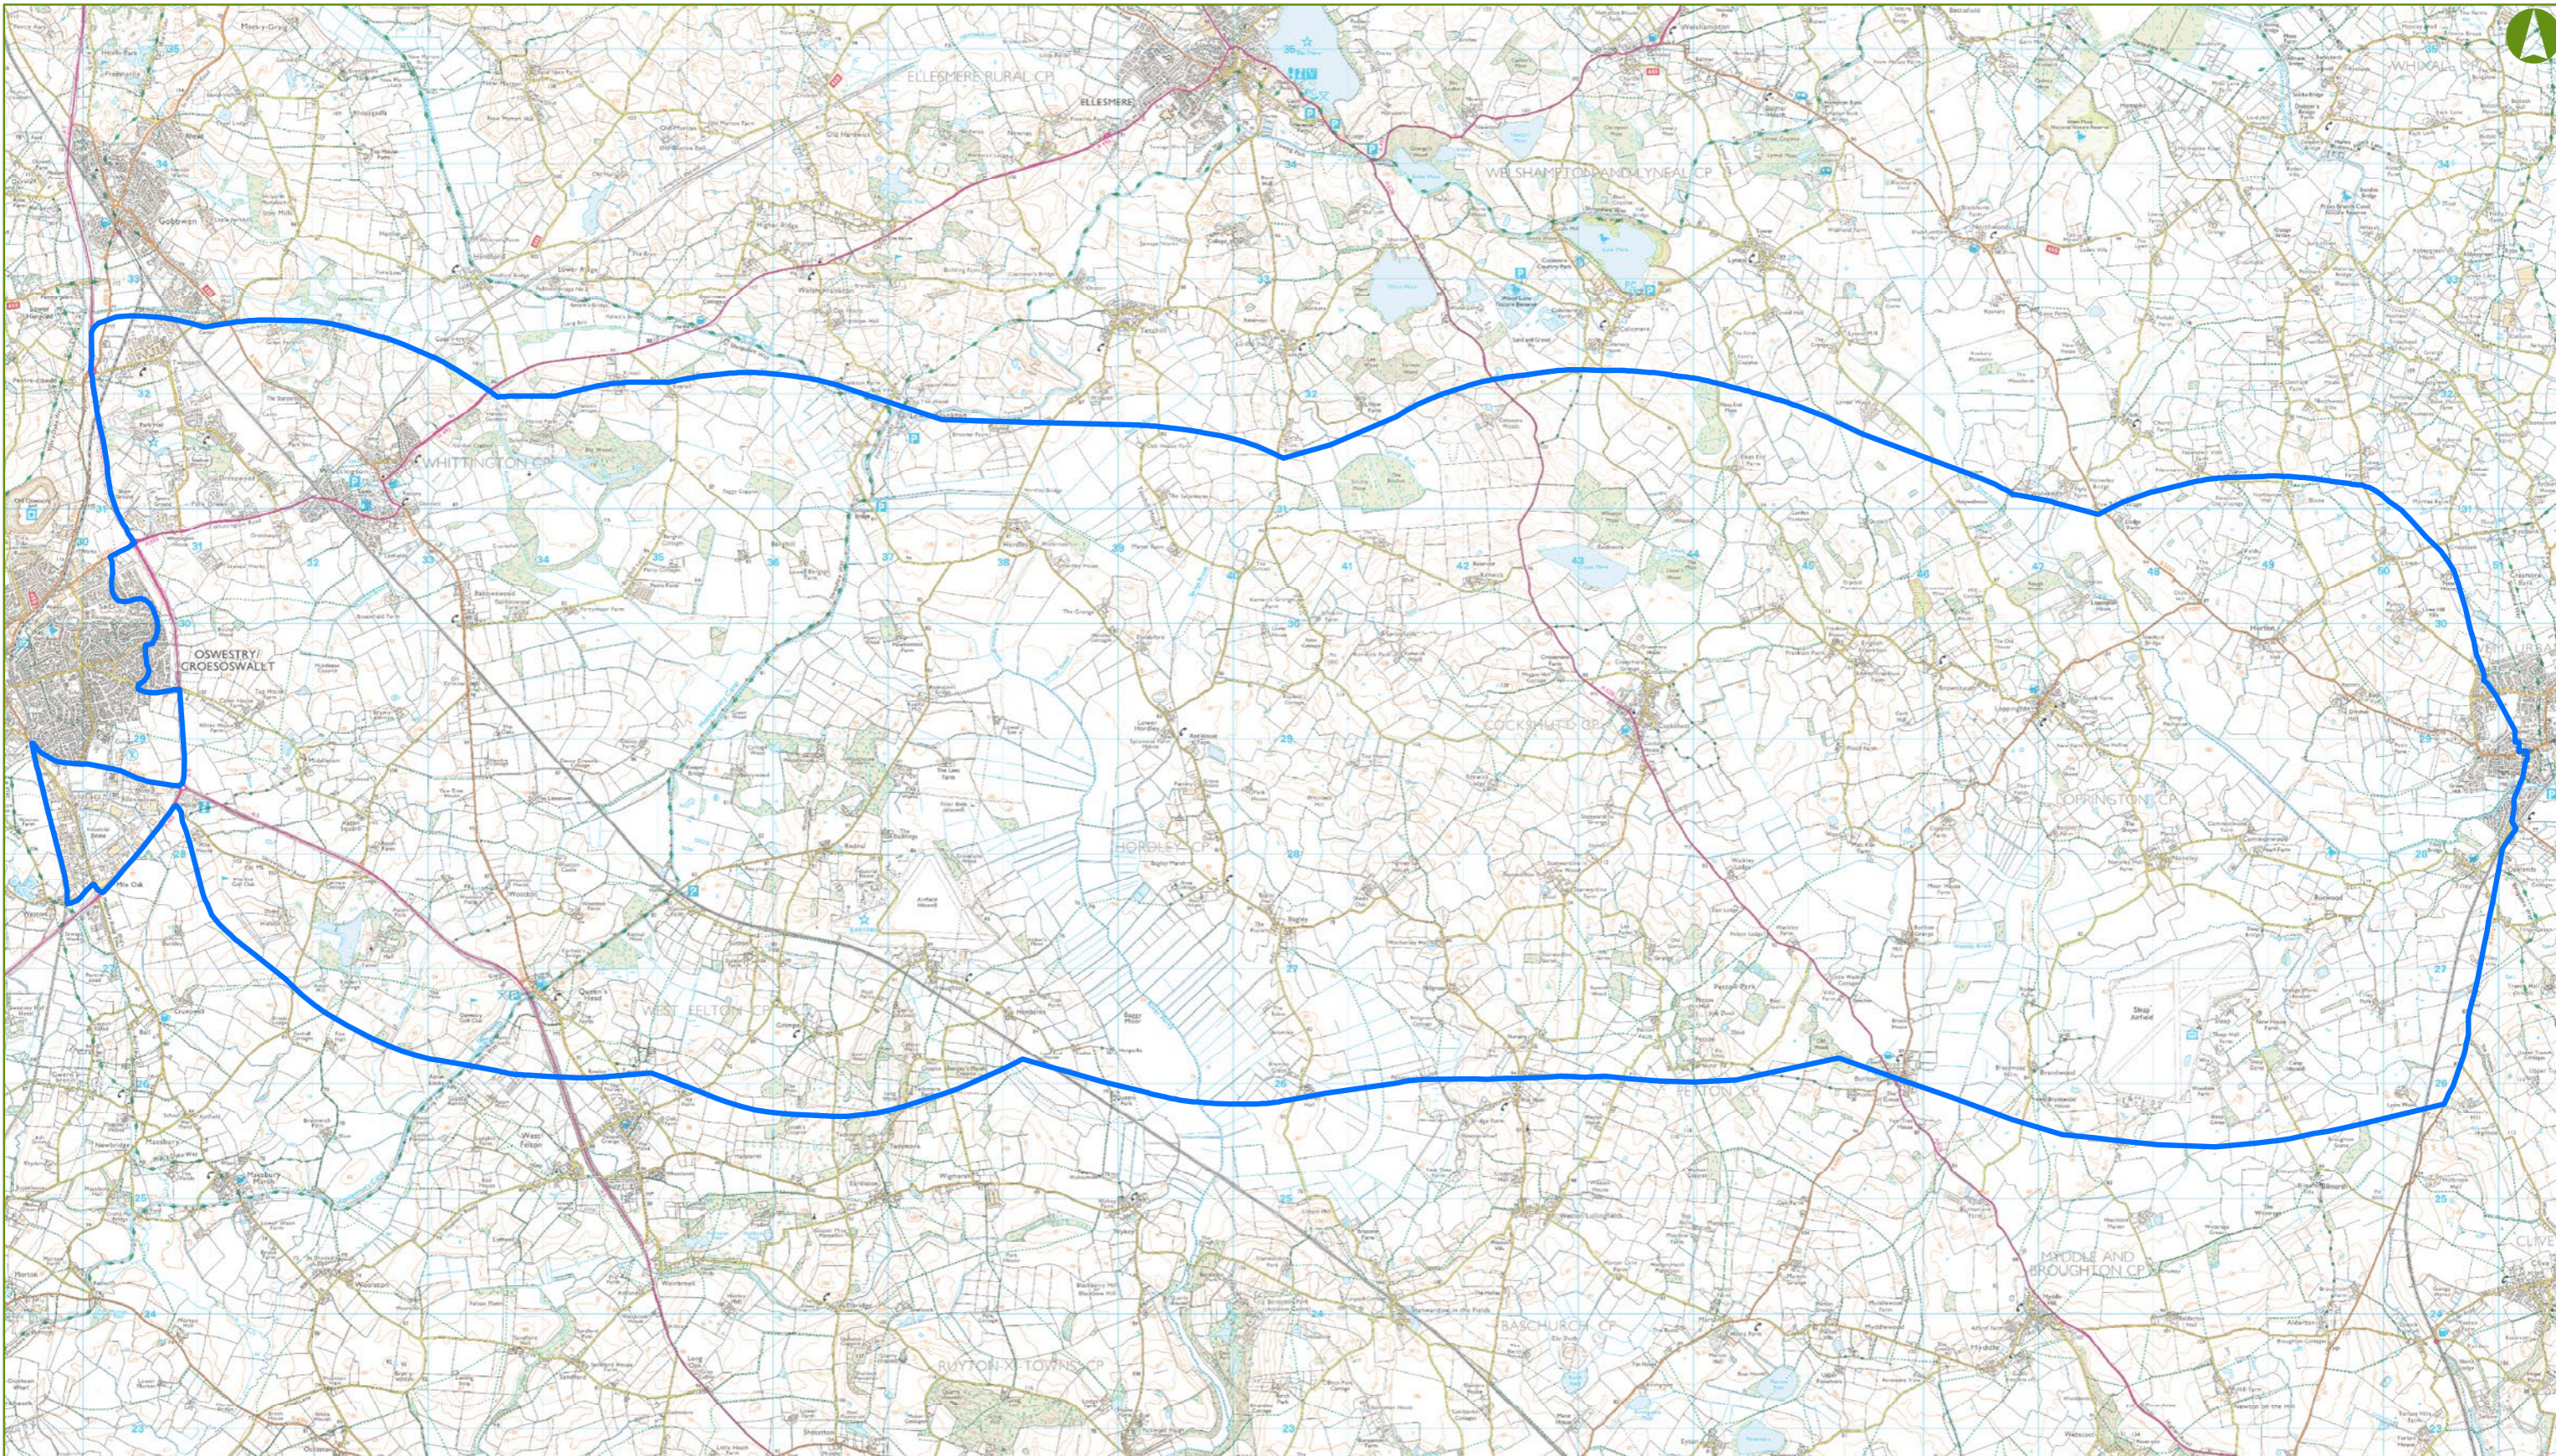

KEY

 CONSULTATION ZONE


Notes:



The Draft Order Limits comprises the construction and operations corridor, temporary access, laydown areas, undergrounding of the new 132 kV cable, and the undergrounding of existing lower voltage overhead line where indicated.


The Construction and Operations corridor generally has a width of 25m in total, centred on the Preferred Line Route. In general, the corridor width for undergrounding is 10m and the corridor for access routes is 5m.

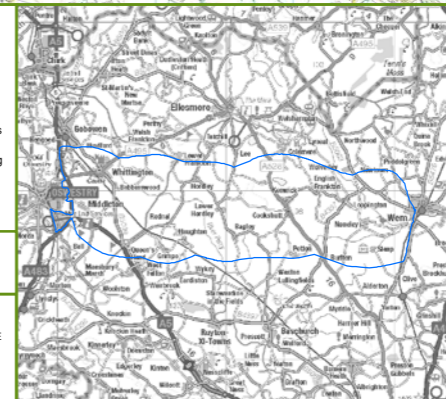

BACKGROUND MAPPING INFORMATION HAS BEEN REPRODUCED FROM THE ORDNANCE SURVEY MAP BY PERMISSION OF ORDNANCE SURVEY ON BEHALF OF THE CONTROLLER OF HER MAJESTY'S STATIONERY OFFICE. CROWN COPYRIGHT AND DATABASE RIGHTS 2017. ORDNANCE SURVEY 0100031873. CONTAINS OS DATA © CROWN COPYRIGHT AND DATABASE RIGHT 2017.



o	14/11/2017	PEIR	KC	ZF	SG
Rev	Date	Description	Made	Chkd	App'd
 					
Scheme Name: REINFORCEMENT TO NORTH SHROPSHIRE ELECTRICITY DISTRIBUTION NETWORK: 132 kV ELECTRICAL CIRCUIT FROM OSWESTRY TO WEM					
Chapter: CHAPTER 4: CONSULTATION					
Document Title: FIGURE 4.2 CONSULTATION ZONE FOR STATUTORY CONSULTATION					
Drawn:	Checked:	Approved:	Date:	Sheet:	Rev:
KC	ZF	SG	14/11/2017	1 OF 1	0
Document Type: FIGURE		Scale: 1:55,000	Sheet Size: A3 (420 mm x 297 mm)		

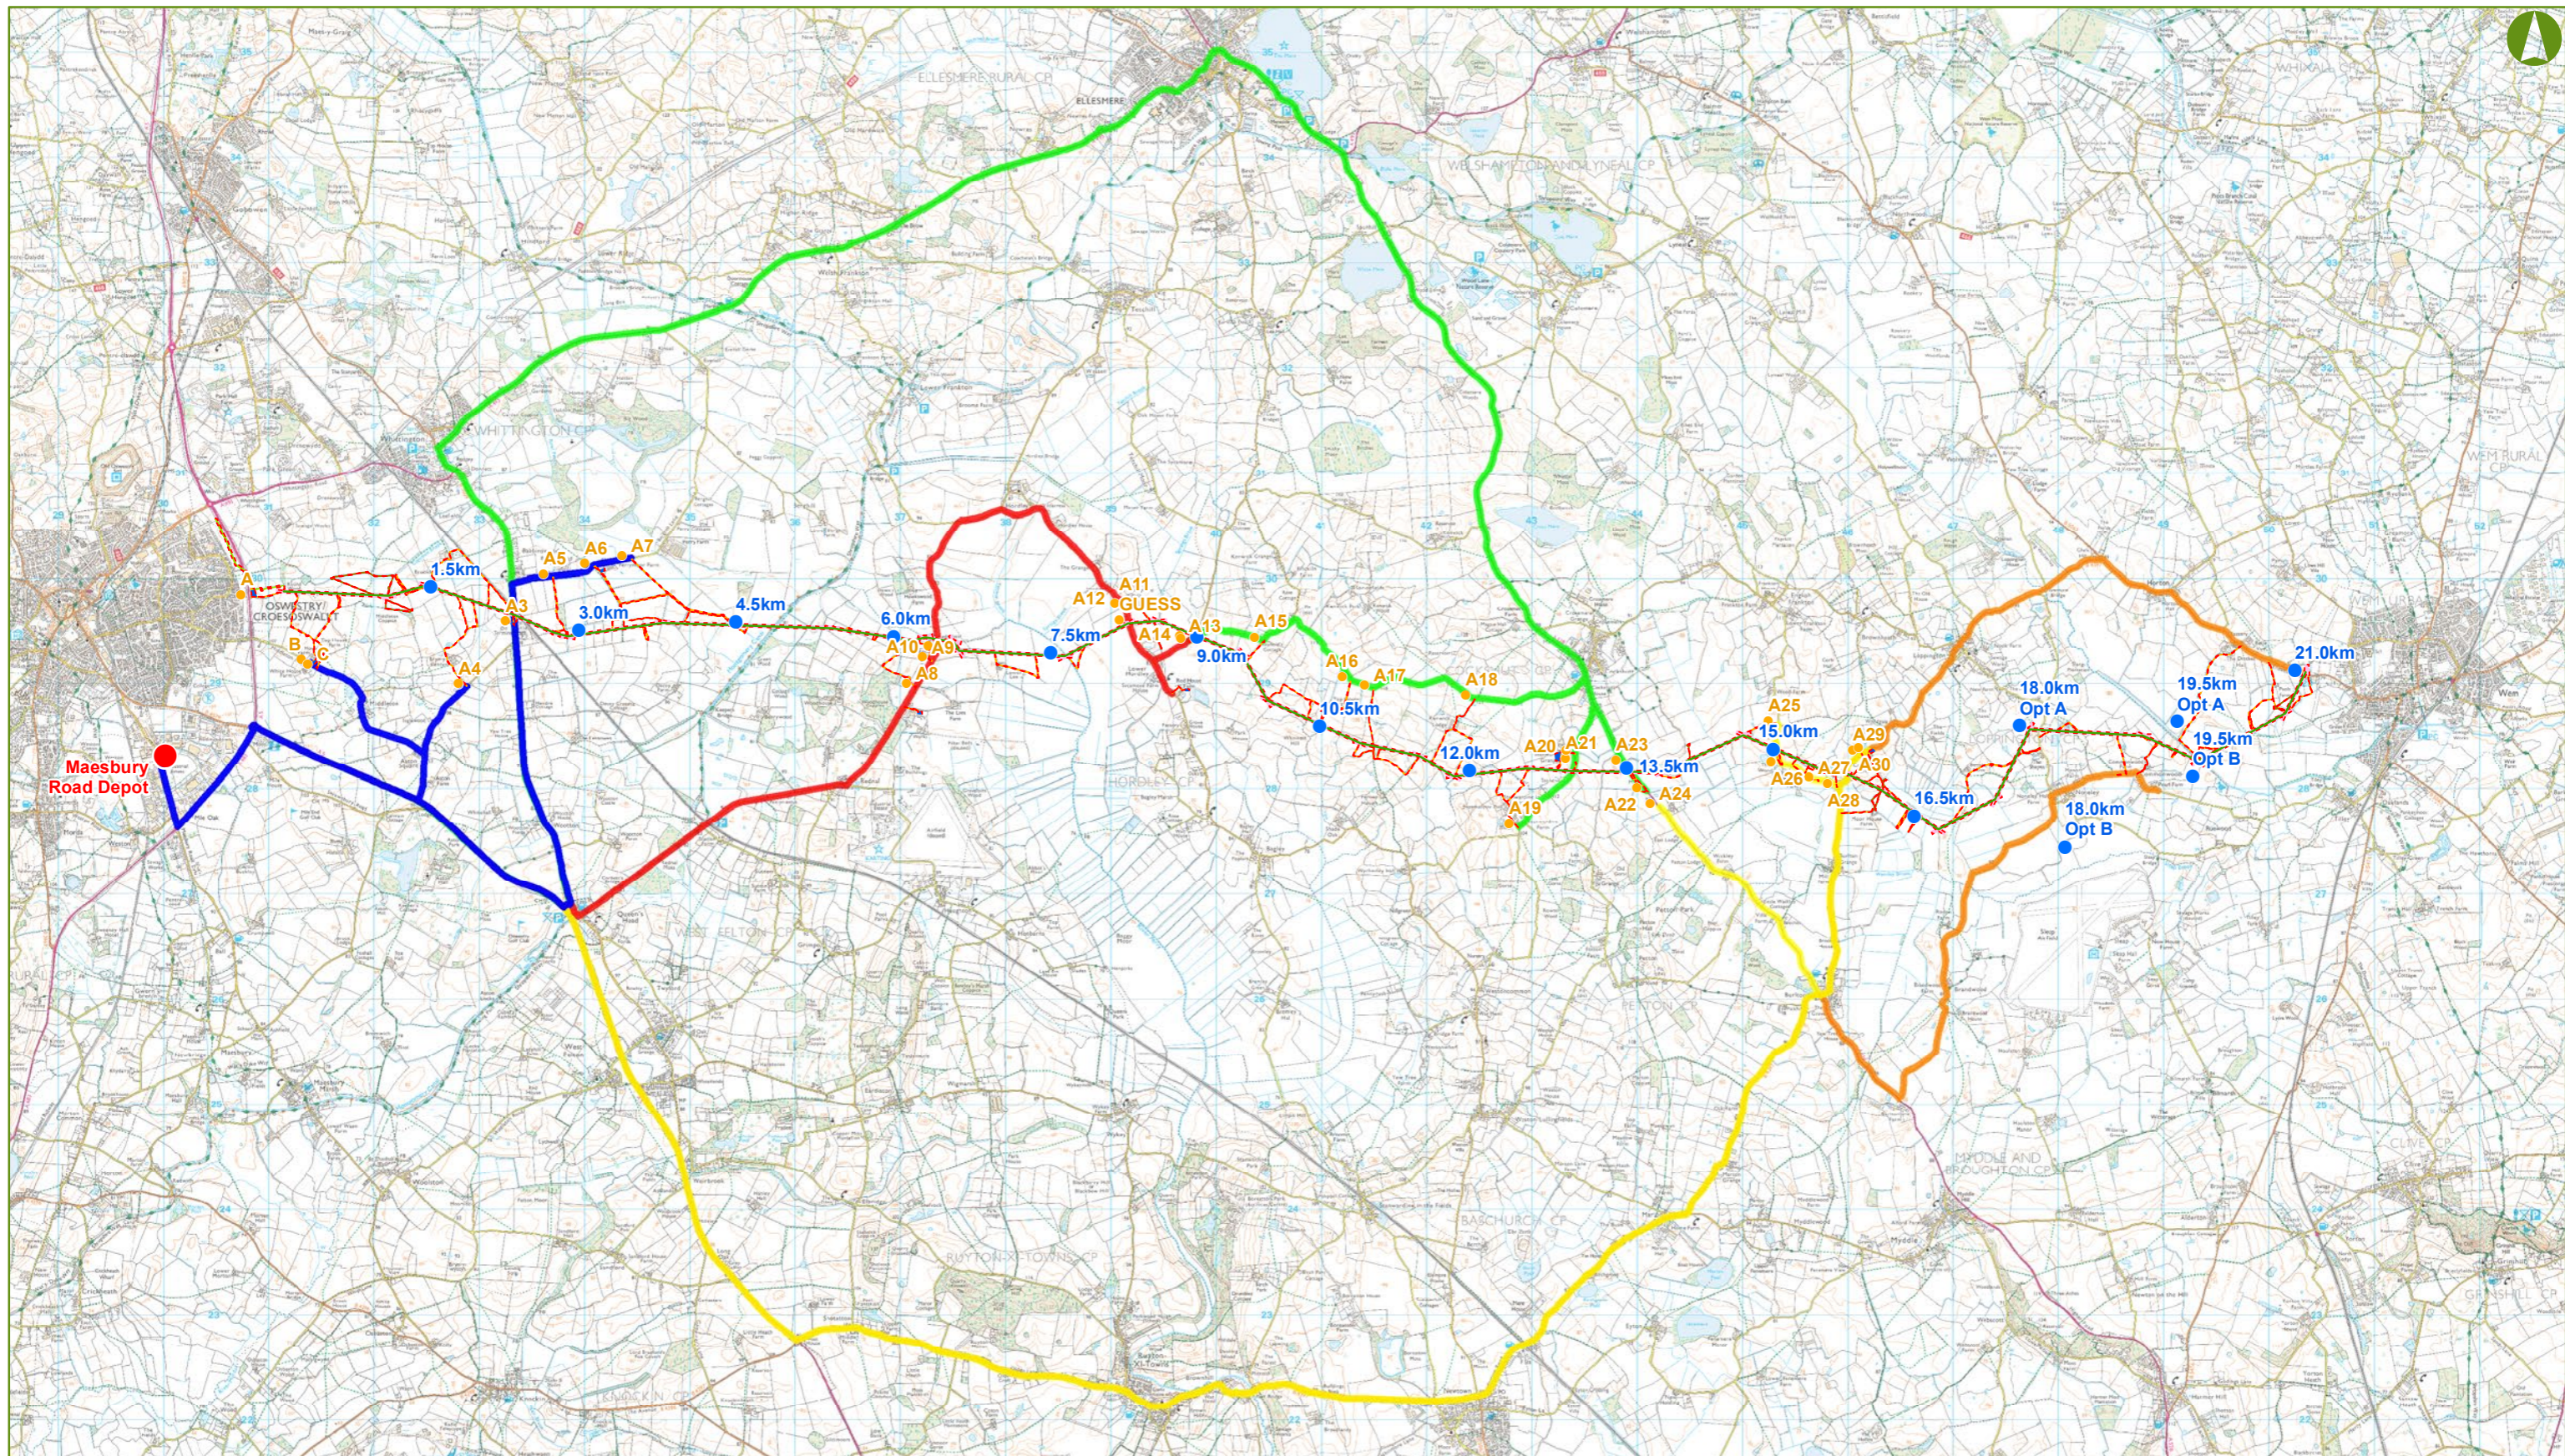


KEY		ACCESS ROUTE SECTION:	
	PREFERRED LINE ROUTE (OF THE 132 kV OVERHEAD LINE)		0 - 4.5km
	CONSTRUCTION AND OPERATIONS CORRIDOR		4.5km - 9.0km
	40m CONSULTATION BOUNDARY		9.0km - 13.5km
	PROPOSED 132 kV UNDERGROUND CABLE		13.5km - 16.5km
	PROPOSED TEMPORARY ACCESS		16.5km (OPTIONS A & B)
	PROPOSED TEMPORARY LAYDOWN		
	PROPOSED UNDERGROUND ROUTE OF EXISTING LOWER VOLTAGE OVERHEAD LINE BEING REMOVED		
	ASSUMED ORIGIN - MAESBURY ROAD DEPOT		
	LINE SECTIONS		
	ACCESSES		

Notes:
 The Draft Order Limits comprises the construction and operations corridor, temporary access, laydown areas, undergrounding of the new 132 kV cable, and the undergrounding of existing lower voltage overhead line where indicated.
 The Construction and Operations corridor generally has a width of 25m in total, centred on the Preferred Line Route. In general, the corridor width for undergrounding is 10m and the corridor for access routes is 5m.



BACKGROUND MAPPING INFORMATION HAS BEEN REPRODUCED FROM THE ORDNANCE SURVEY MAP BY PERMISSION OF ORDNANCE SURVEY ON BEHALF OF THE CONTROLLER OF HER MAJESTY'S STATIONERY OFFICE. CROWN COPYRIGHT AND DATABASE RIGHTS 2017. ORDNANCE SURVEY 0100031873. CONTAINS OS DATA © CROWN COPYRIGHT AND DATABASE RIGHT 2017.

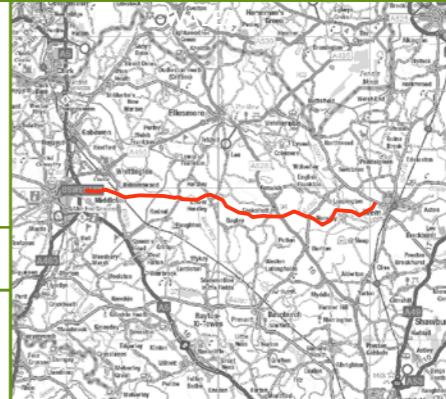

o	14/11/2017	PEIR	KC	GB	SG
Rev	Date	Description	Made	Chkd	App'd
Scheme Name: REINFORCEMENT TO NORTH SHROPSHIRE ELECTRICITY DISTRIBUTION NETWORK: 132 kV ELECTRICAL CIRCUIT FROM OSWESTRY TO WEM					
Chapter: CHAPTER 4: APPENDIX 4.2					
Document Title: FIGURE 4.3 CONSTRUCTION ROUTES					
Drawn:	KC	Checked:	GB	Approved:	SG
Date:	14/11/2017	Sheet:	1 OF 1	Rev:	0
Document Type:	FIGURE	Scale:	1:60,000	Sheet Size:	A3 (420 mm x 297 mm)